
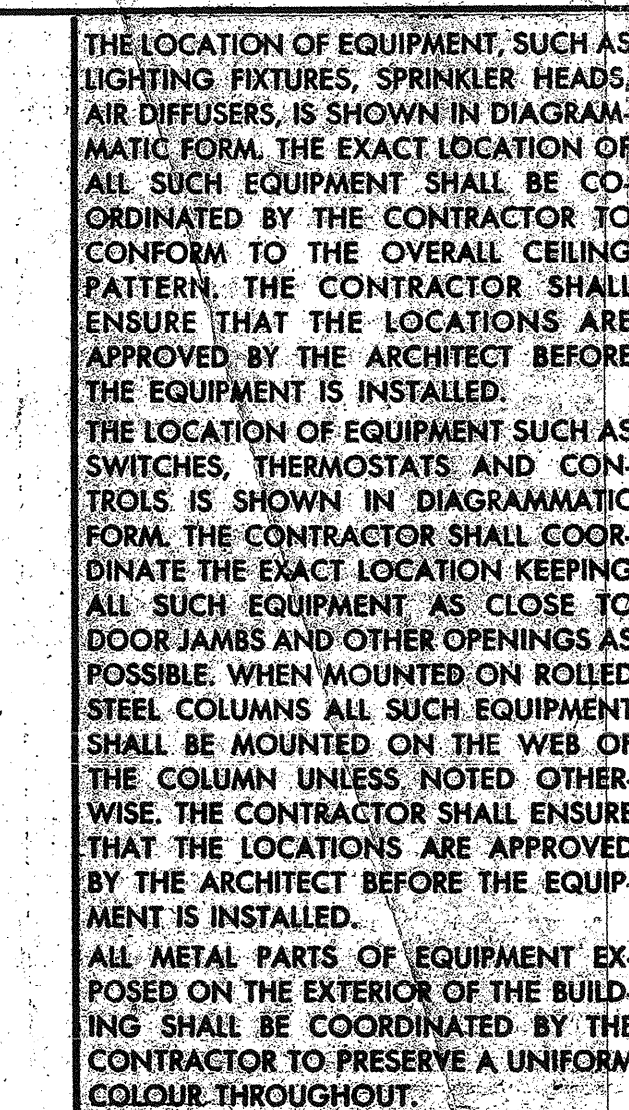


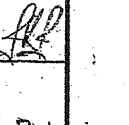

NOTES:
*1. FOR EQUIPMENT LAYOUT DETAIL
OF ROOMS # 203 & 204. REF
TO DWG. 69039-515.

6		AS BUILT	Aug 18/94	CL
5		REV FOR CCO. 3rd	Aug 30/94	CL
4		REV. FOR C.C.O. #39	8/28/94	CL
3		REV FOR CONSTRUCTION	21/11/94	CL
2		REV. FOR ADDENDUM No.1	21/11/94	CL
1		REV. FOR BULLETIN No.1,2,3,4	21/11/94	CL

No.	Ref.	Description	Date	Ch
Revisions				

Drawn GM	 NORTH
Date 5 FEB 1971	
Checked CWA <i>[Signature]</i>	
Pre-Design	
Design PW	
Architectural JAG	
Structural BU	
Heating AL	
Sanitary AL	
Electrical CA	
Specifications RK	
Process	
Printed	

JAN 15 1981

All measurements must be checked on the work by the contractor.

All prints and specifications are the property of the architects and must be returned at the completion of the work.

Date 21 MAY 71

NATIONAL LIFE
OF CANADA

Head Office Building
University Avenue, Toronto, Canada

**Searle
Wilbee
Rowland**

Architects
Engineers
Planners

Toronto
Canada

This drawing is the property of
Davidson & Boy

Neish Owen Rowland & Co.

Sheet
Title

ELECTRICAL
2ND FLOOR PLAN
POWER

Scales $1/8" = 1'-0"$

Order Number **69039-509**