



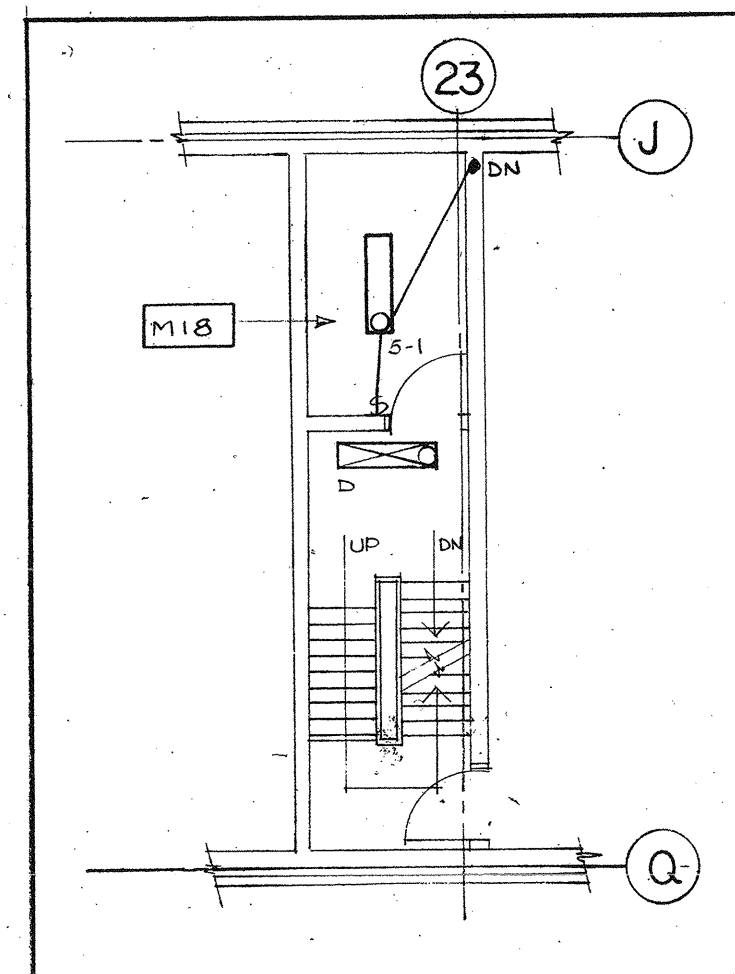

① STAIR # S6 LIGHTING AT INTERMEDIATE LANDING BETWEEN MECH. FLOOR AND ROOF
SCALE: 1/8" = 1'-0"

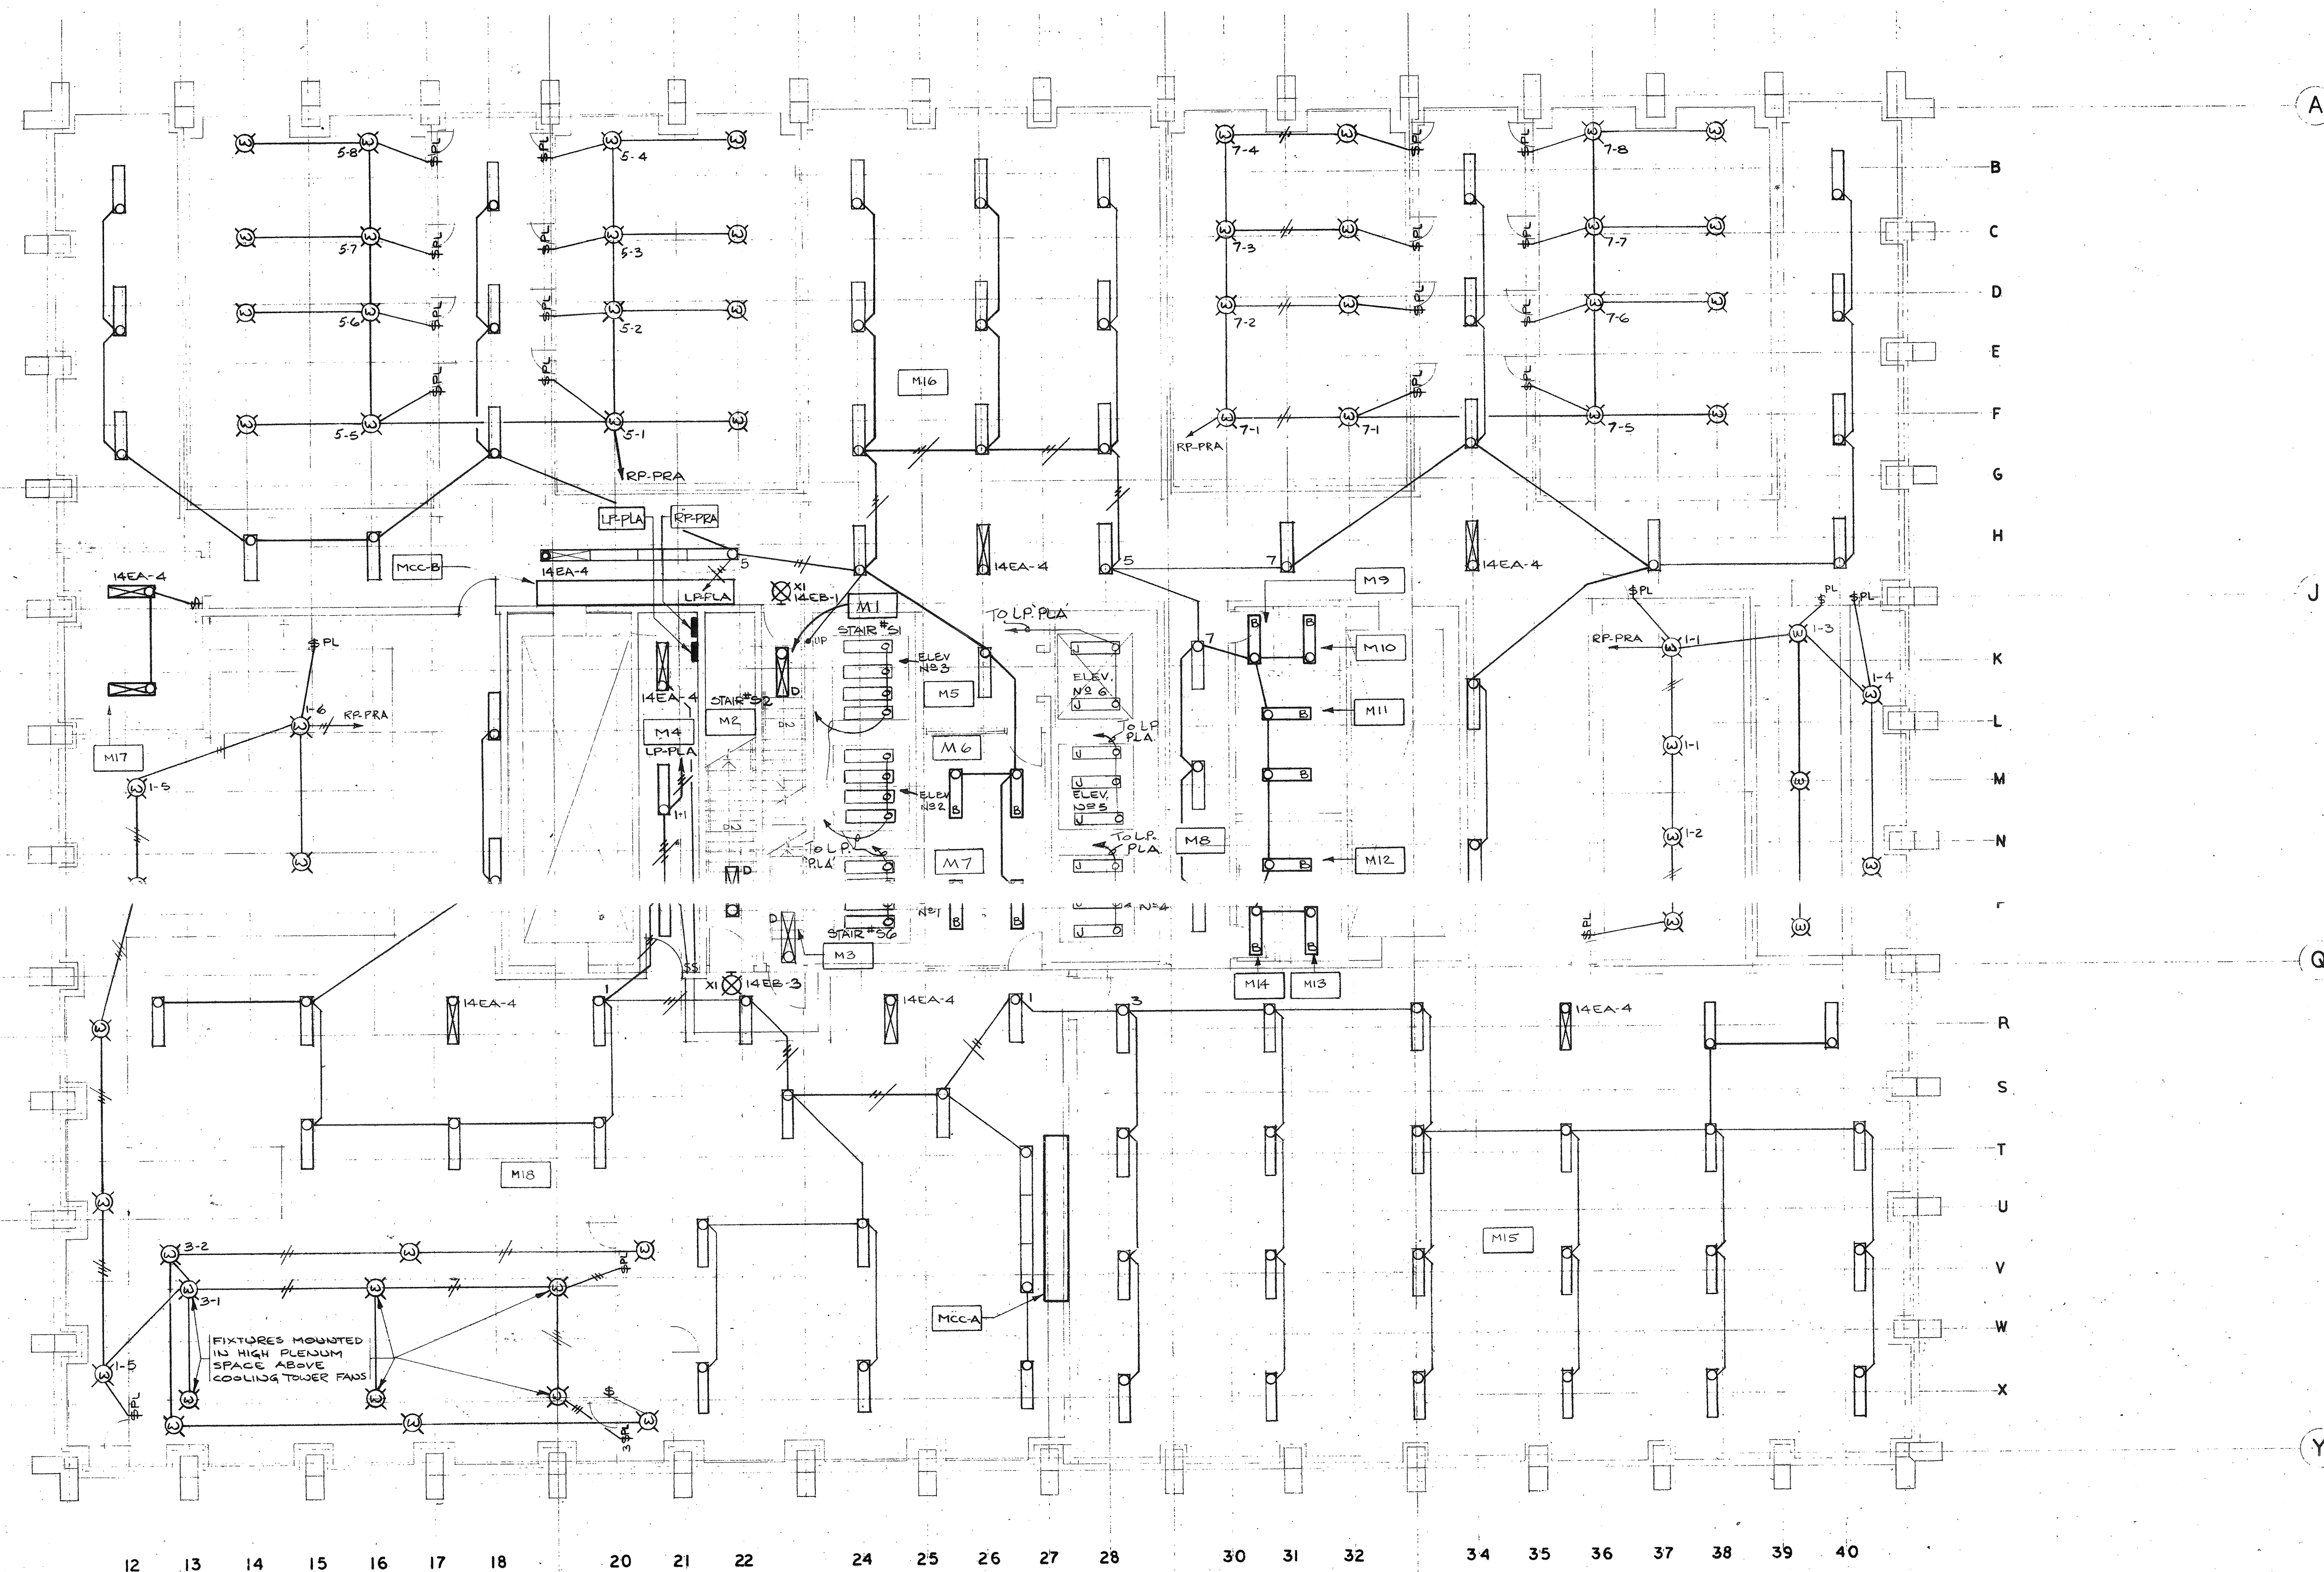

12 13 14 15 16 17 18 20 21 22 24 25 26 27 28 30 31 32 34 35 36 37 38 39 40

THE LOCATION OF EQUIPMENT, SUCH AS LIGHTING FIXTURES, SPRINKLER HEADS, AIR DIFFUSERS, IS SHOWN IN DIAGRAMMATIC FORM. THE EXACT LOCATION OF ALL SUCH EQUIPMENT SHALL BE CO-ORDINATED BY THE CONTRACTOR TO CONFORM TO THE OVERALL CEILING PATTERN. THE CONTRACTOR SHALL ENSURE THAT THE LOCATIONS ARE APPROVED BY THE ARCHITECT BEFORE THE EQUIPMENT IS INSTALLED.

THE LOCATION OF EQUIPMENT SUCH AS SWITCHES, THERMOSTATS AND CONTROLS IS SHOWN IN DIAGRAMMATIC FORM. THE CONTRACTOR SHALL CO-ORDINATE THE EXACT LOCATION KEEPING ALL SUCH EQUIPMENT AS CLOSE TO DOOR JAMBS AND OTHER OPENINGS AS POSSIBLE. WHEN MOUNTED ON ROLLED STEEL COLUMNS ALL SUCH EQUIPMENT SHALL BE MOUNTED ON THE WEB OF THE COLUMN UNLESS NOTED OTHERWISE. THE CONTRACTOR SHALL ENSURE THAT THE LOCATIONS ARE APPROVED BY THE ARCHITECT BEFORE THE EQUIPMENT IS INSTALLED.

ALL METAL PARTS OF EQUIPMENT EXPOSED ON THE EXTERIOR OF THE BUILDING SHALL BE CO-ORDINATED BY THE CONTRACTOR TO PRESERVE A UNIFORM COLOUR THROUGHOUT.

NOTES:
#1 ALL FLUORESCENT FIXTURES ON THIS DRAWING SHALL BE TYPE 12 UNLESS OTHERWISE NOTED.
#2 ALL LIGHTING FIXTURES SHOWN ON THIS DRAWING ARE FOR QUANTITY ONLY. EXACT LOCATIONS SHALL BE CO-ORDINATED WITH OTHER TRADES TO ASSURE PROPER INSTALLATION.
#3 ALL HANGING LIGHTS TYPE 12 SHALL BE HANGING INSIDE MECHANICAL AIR PLenums.

No.	Rev.	Description	Date	Ch'd
5		AS BUILT		
4		REV FOR C.O. 10-8-82		
3		REV FOR C.O. 10-8-82		
2		REV FOR C.O. 10-8-82		
1		REV FOR C.O. 10-8-82		

Revisions

Drawn C.D.

Date 8 FEB 1971

Checked C.A.

Pre-Design Pvi

Design Pvi

Architectural-JAR

Structural BU

Heating AU

Sanitary AU

Electrical CA

Specifications Rv

Process

Printed

All measurements must be checked on the work by the contractor.

All prints and specifications are the property of the architects and must be returned at the completion of the work.

This drawing not to be used for construction purposes until countersigned by:

Date 21 MAR 71

NATIONAL LIFE OF CANADA

Head Office Building
University Avenue, Toronto, Canada

Searle Wilbee Rowland
Architects
Engineers
Planners
Toronto
Canada

This drawing is the property of
Neil Owen Rowland & Roy

ELECTRICAL
MECHANICAL FLOOR
PLAN - LIGHTING

Sheet
Title
Drawing #

Scales 1/8" = 1'-0"

Sheet Number 69039-513